

Command= 210-

Point#, Start#-End# or G#= 1-100

Bearing	Distance	Elev	Descrip	Pnt.	Northing	Easting	Type
-----12-27-2023-----19:25:44-----D:...\BMHOME1							
	50.00			1	5000.0000	5000.0000	
				2	5147.6198	5024.6884	TRA
				3	5178.5433	4877.9105	TRA
				4	5188.8848	4892.7164	TRA
				5	5203.3822	4882.1491	TRA
				6	5326.4092	4903.1109	TRA
				7	5354.9021	4755.8419	TRA
	50.00		1setspk	50	5186.1399	4906.1218	
	49.99		2stspk	51	5172.5068	5078.8547	TRA
	50.81		topipin	52	5178.0349	4877.6843	SS
	50.55		baseipin	53	5188.8899	4892.6905	SS
	49.37		baseipin	54	5203.2626	4882.2103	SS
	52.29		@fnc	55	5301.5902	4898.0803	SS
	51.89		corhse	56	5233.3295	4927.2901	SS
	51.84		corhse	57	5208.0282	4923.2769	SS
	51.92		corhse	58	5200.3796	4970.9565	SS
	51.71		pad@hse	59	5203.6833	4949.5955	SS
	51.82		corpad	60	5185.5493	4952.4181	SS
	51.87		corpad	61	5190.2215	4979.8389	SS
	51.26		inletcov	62	5248.1023	4977.6517	SS
	51.16		outletco	63	5251.8901	4983.7128	SS
	51.84		corfnc	64	5258.7162	4941.8989	SS
	51.12		corfnc	65	5270.5285	5001.8199	SS
	50.96		pole	66	5252.2161	5002.3835	SS
	51.82		corhse	67	5225.6328	4974.8024	SS
	50.06		pole	68	5254.0955	5032.8197	SS
	49.19		pole	69	5260.4679	5062.0071	SS
	50.33		topipin	70	5147.6198	5024.6884	SS

Point#, Start#-End# or G#= 4-

PROPOSED  
REPLACEMENT DWELLING  
#83 HEMLOCK HAVEN  
TAX MAP 138 LOT 1  
SCALE: 1"=20'


N/F BANCIEWICZ

N09°40'10"E  
124.80'

N36°05'20"W  
17.94'  
18.06'  
N55°04'00"E

N/F NEWCOMB

N78°06'10"W  
150.00'

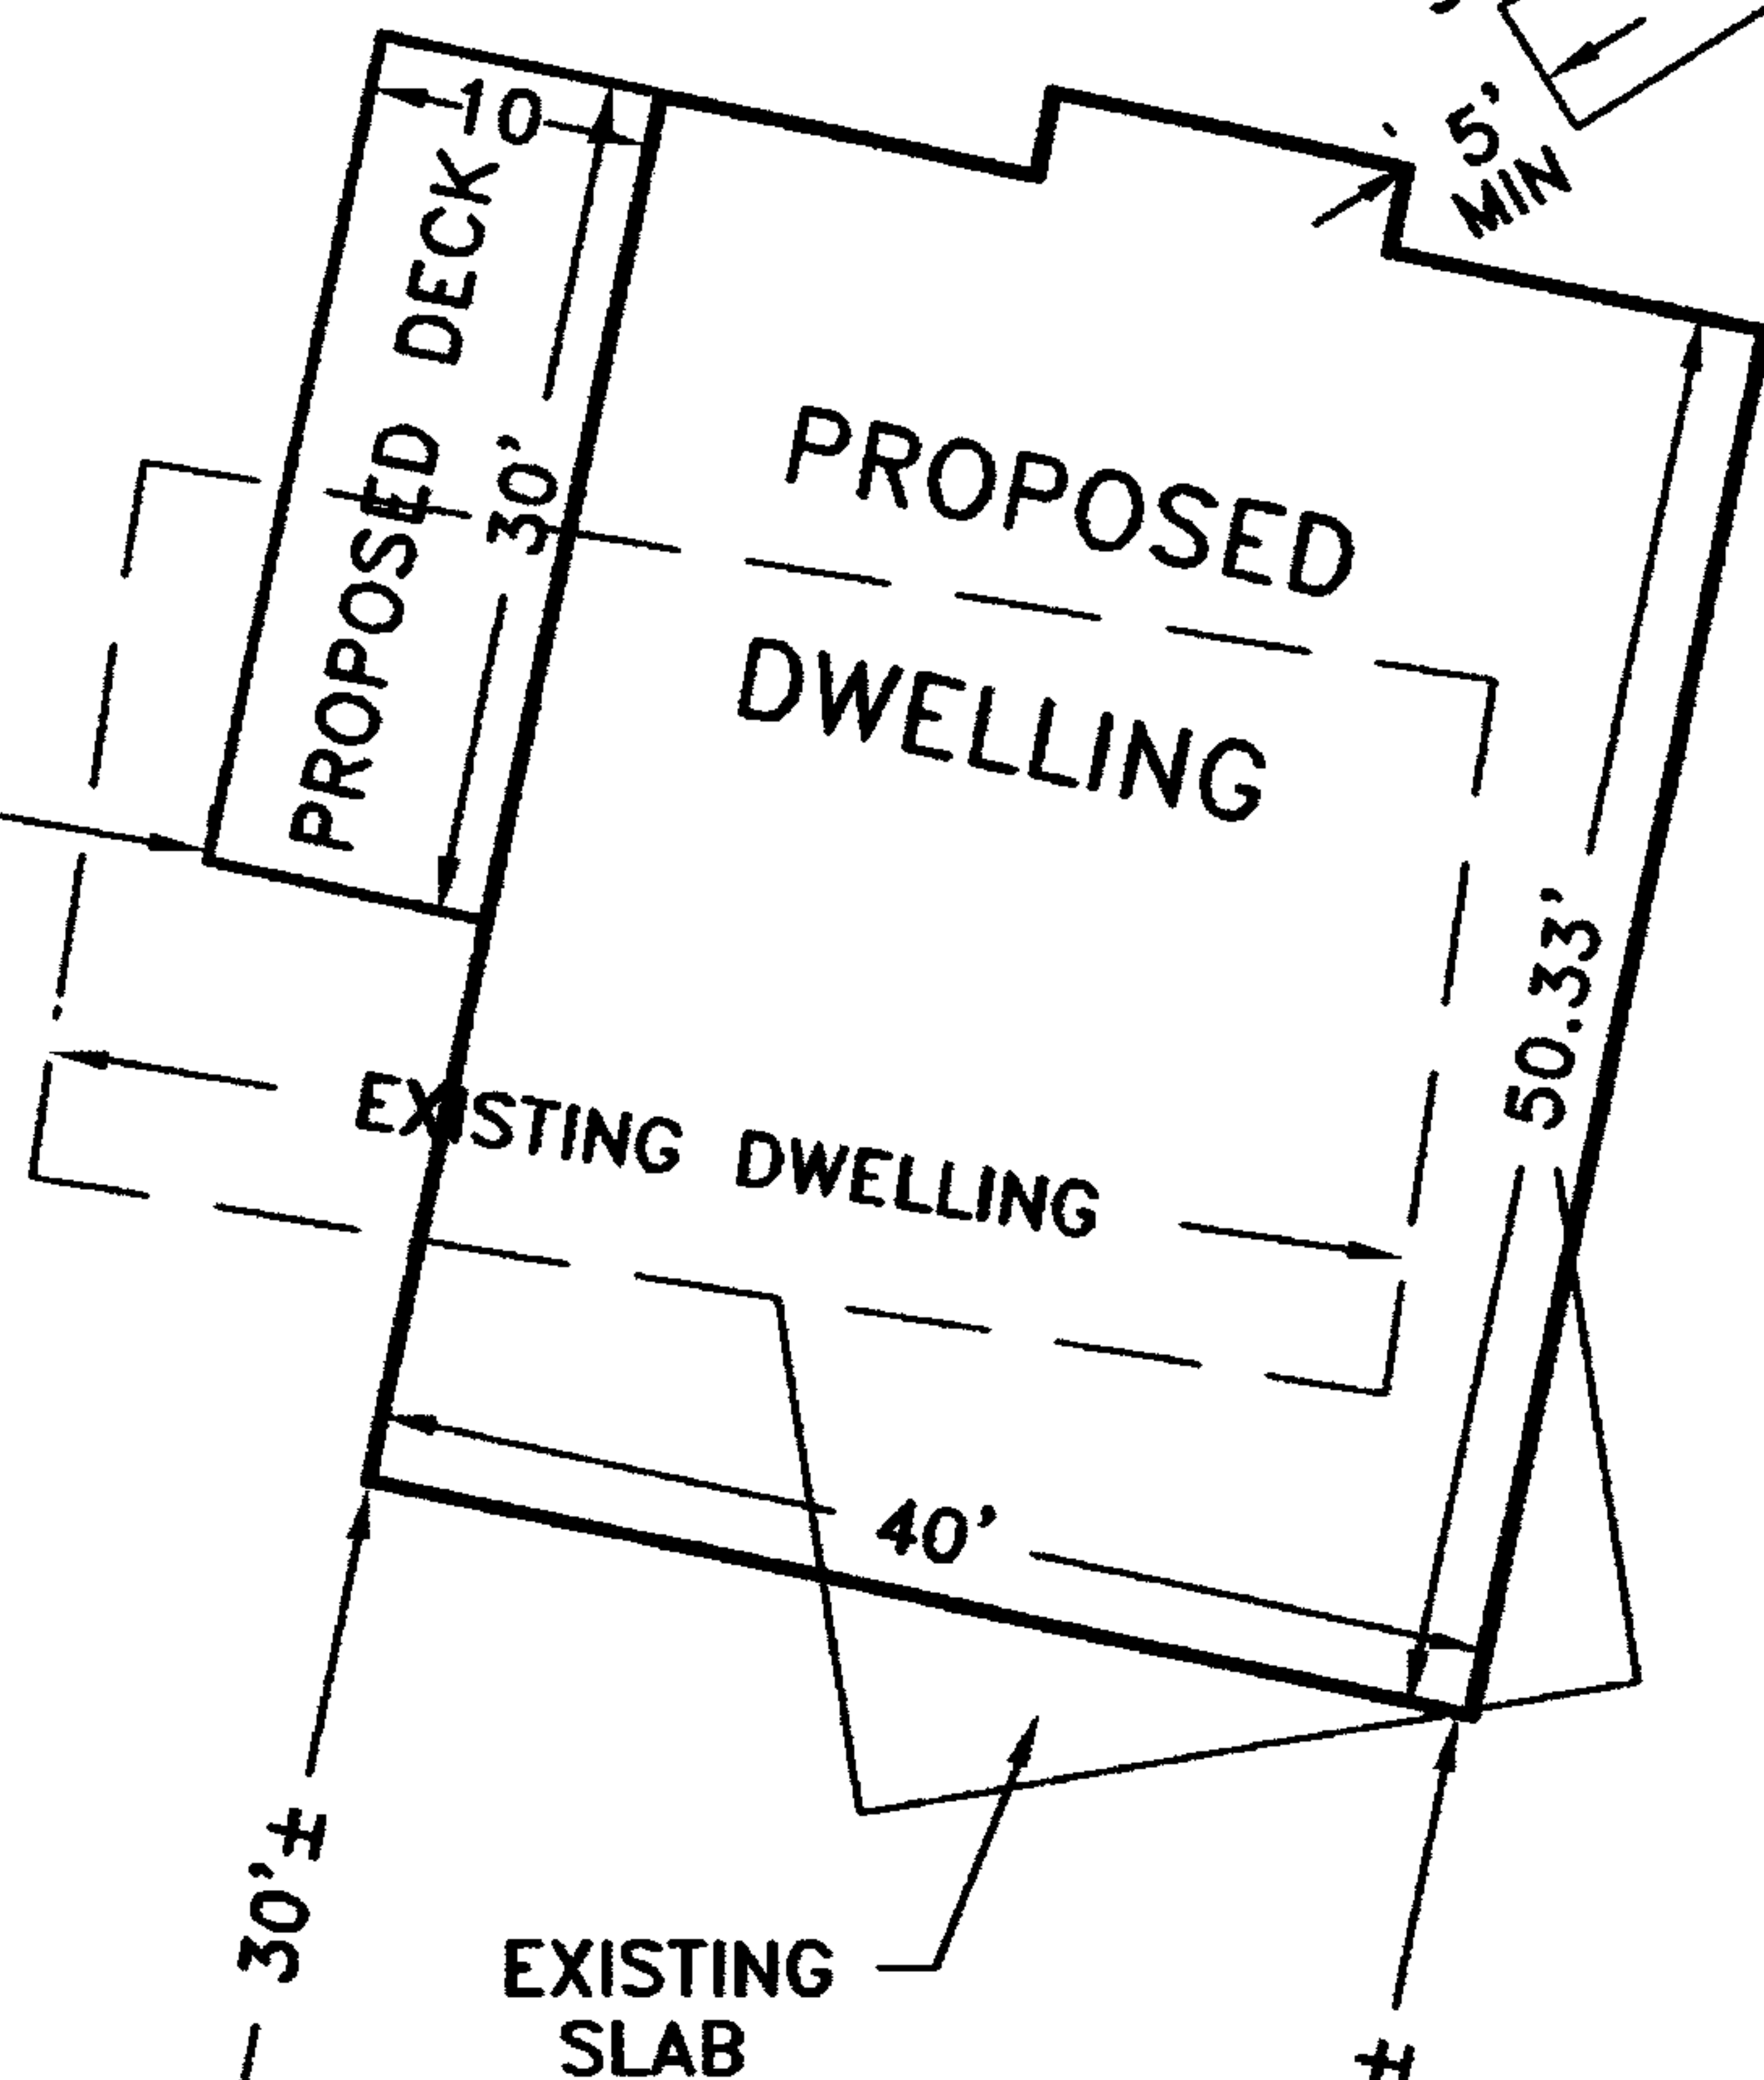

APPROX EXIS  
LEACH FIELD

115'± TO  
PROPERTY LINE

100' EXETER & HAMPTON  
POLE LINE EASEMENT




Bancewicz

1980 ← EXIS house to be moved to 4 seasons

House - 1250 TANK  
Mike has sketches?

Newcomb

2 BEDROOM

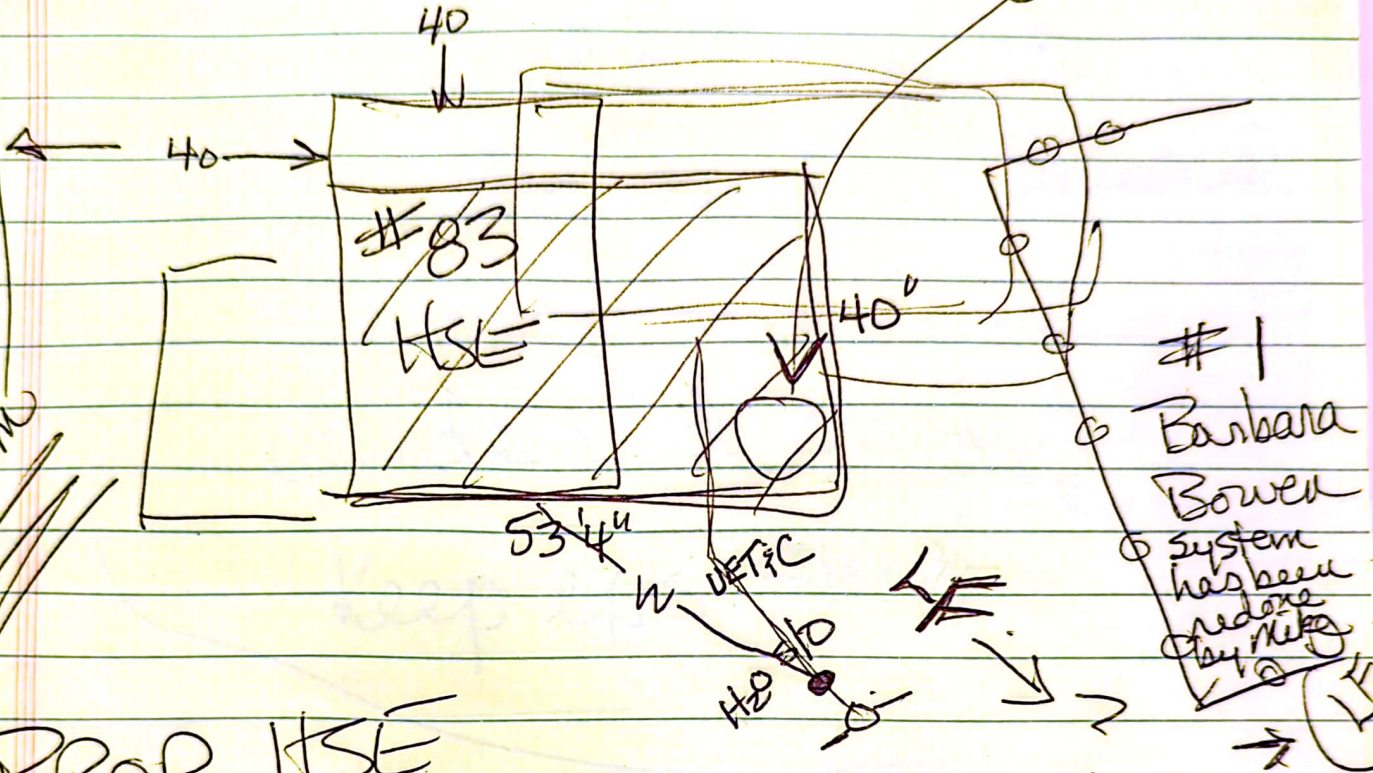

PROP HSE

53 1/4' x 40'

Wants to tie INTO EXIS system New tank

common w/ #1 maybe probably not

FORWARD a BIT MORE FROM where it was


Keep 40' setback from AP

TALK TO MIKE find design?

Dick Parker went to Concord to prove this was a legal site.

community wall 175' radius required



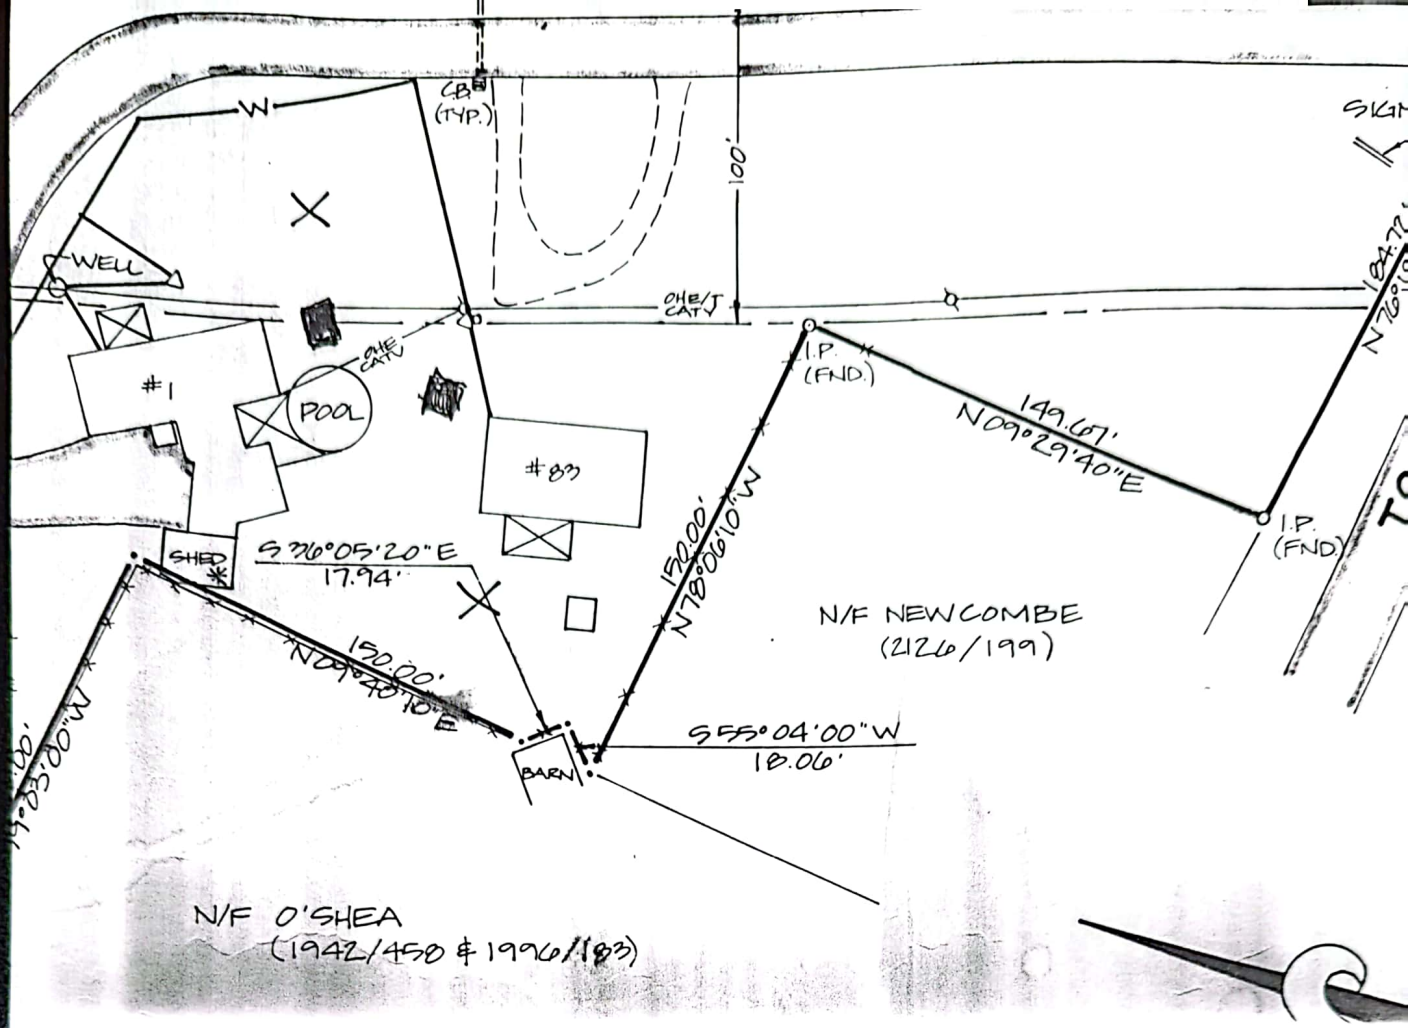

AS-BUILT PLAN  
OF

# HEMLOCK HAVEN IN HAMPTON, N.H.

SCALE: 1" = 50' JAN. 1992  
PARKER SURVEY ASSOC., INC.  
EXETER & SEABROOK, N.H.



SHEET 1 of 2

6440



00'00" E


1106.25'

999.44'

FND IP

10

SIGN

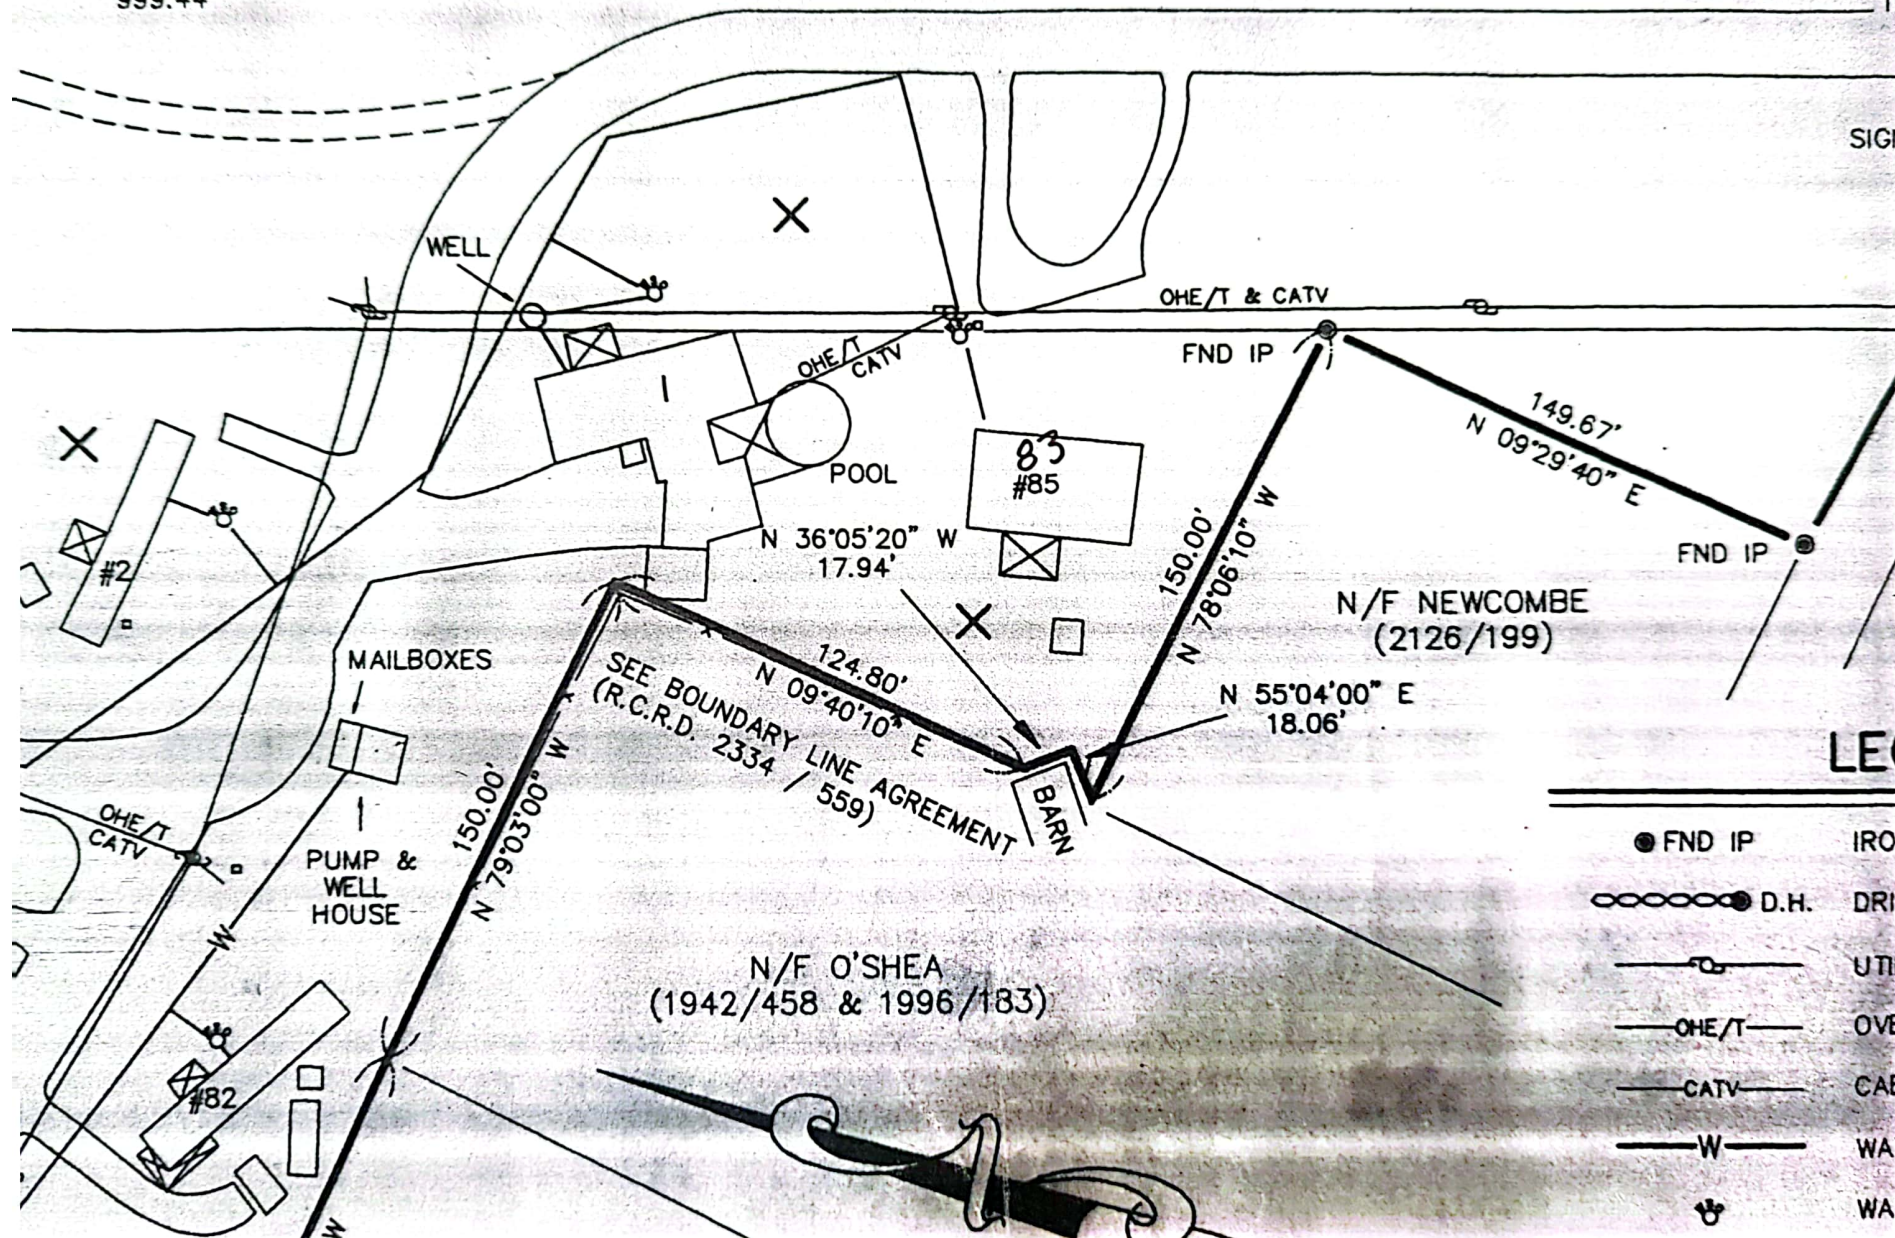

N/F NEWCOMBE  
(2126/199)

SEE BOUNDARY LINE AGREEMENT  
(R.C.R.D. 2334 / 559)

N/F O'SHEA  
(1942/458 & 1996/183)

LEC

● FND IP IRON

○ D.H. DRILL

— UTIL UTILITY

— OHE/T OVERHEAD ELECTRIC/TELEPHONE

— CATV CABLE TELEVISION

— W WATER



⊕ WA WATER







Lot 83  
Hem Haw

# MODEL L5342-11

APPROX 2062 SQ. FT.

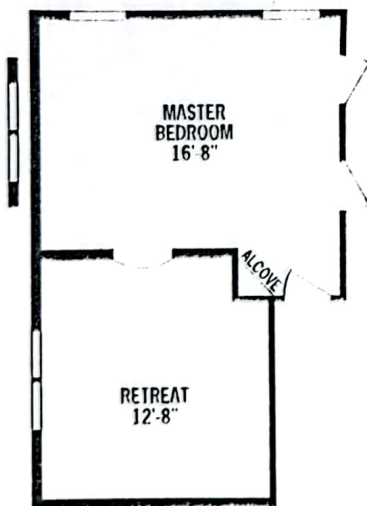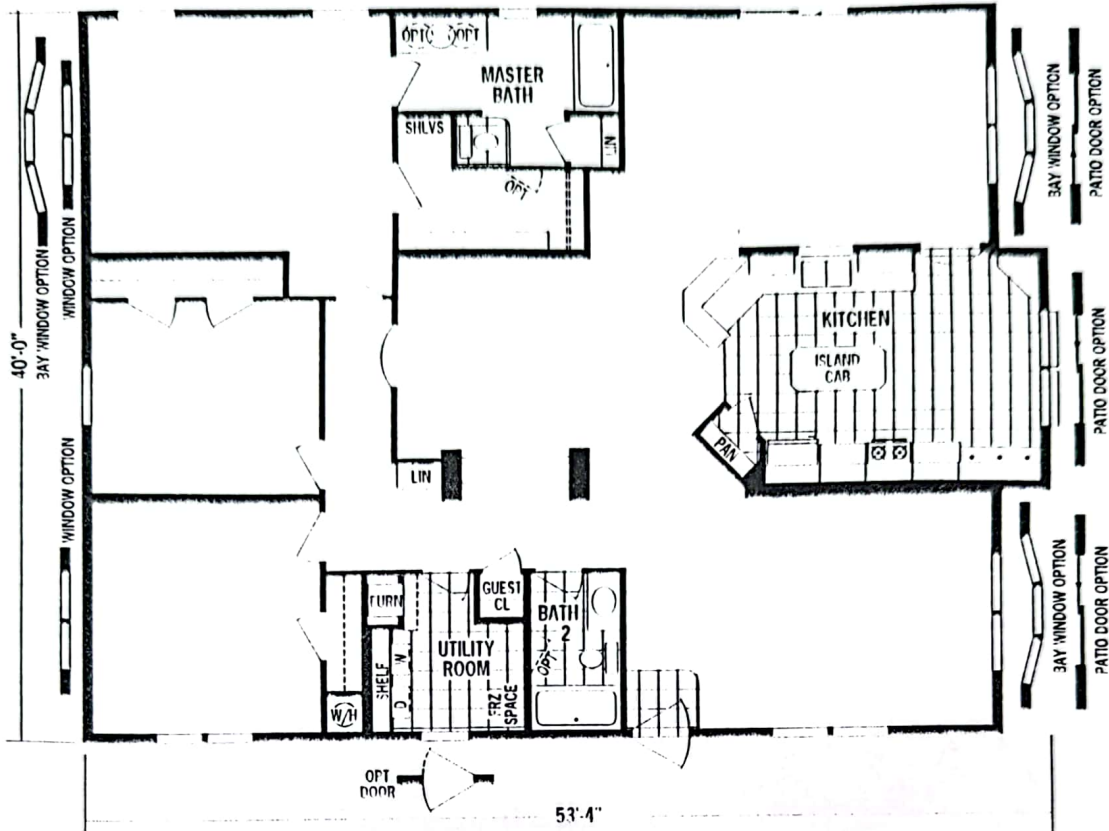




RETREAT OPTION  
REPLACES BEDROOM 3

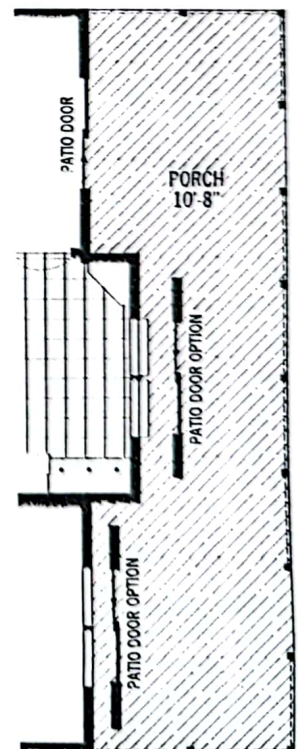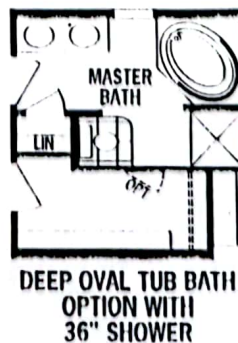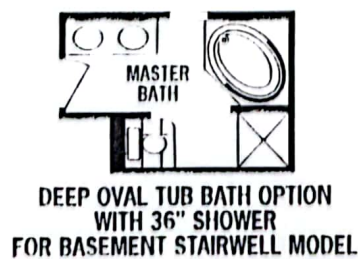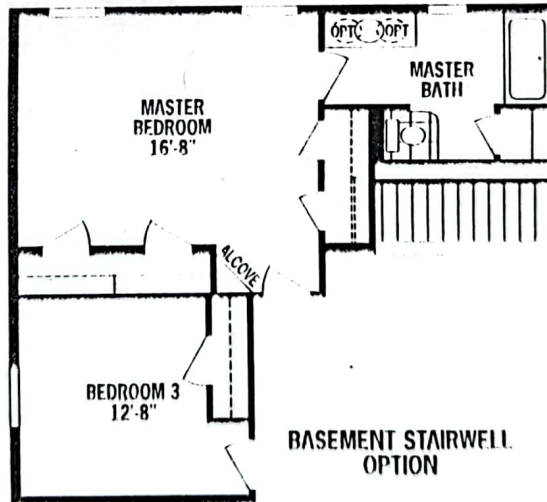

FULL PORCH OPTION



SCALE: 1"=50' JULY 1978  
PARKER SURVEY ASSOC., INC.  
EXETER & SEABROOK, NH.

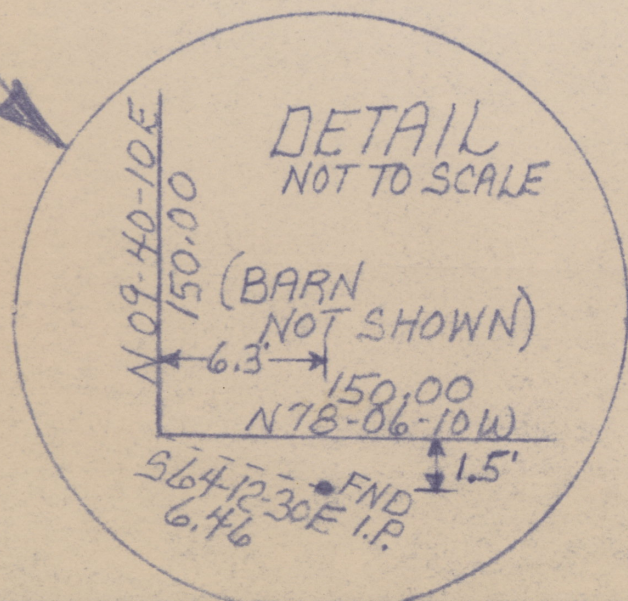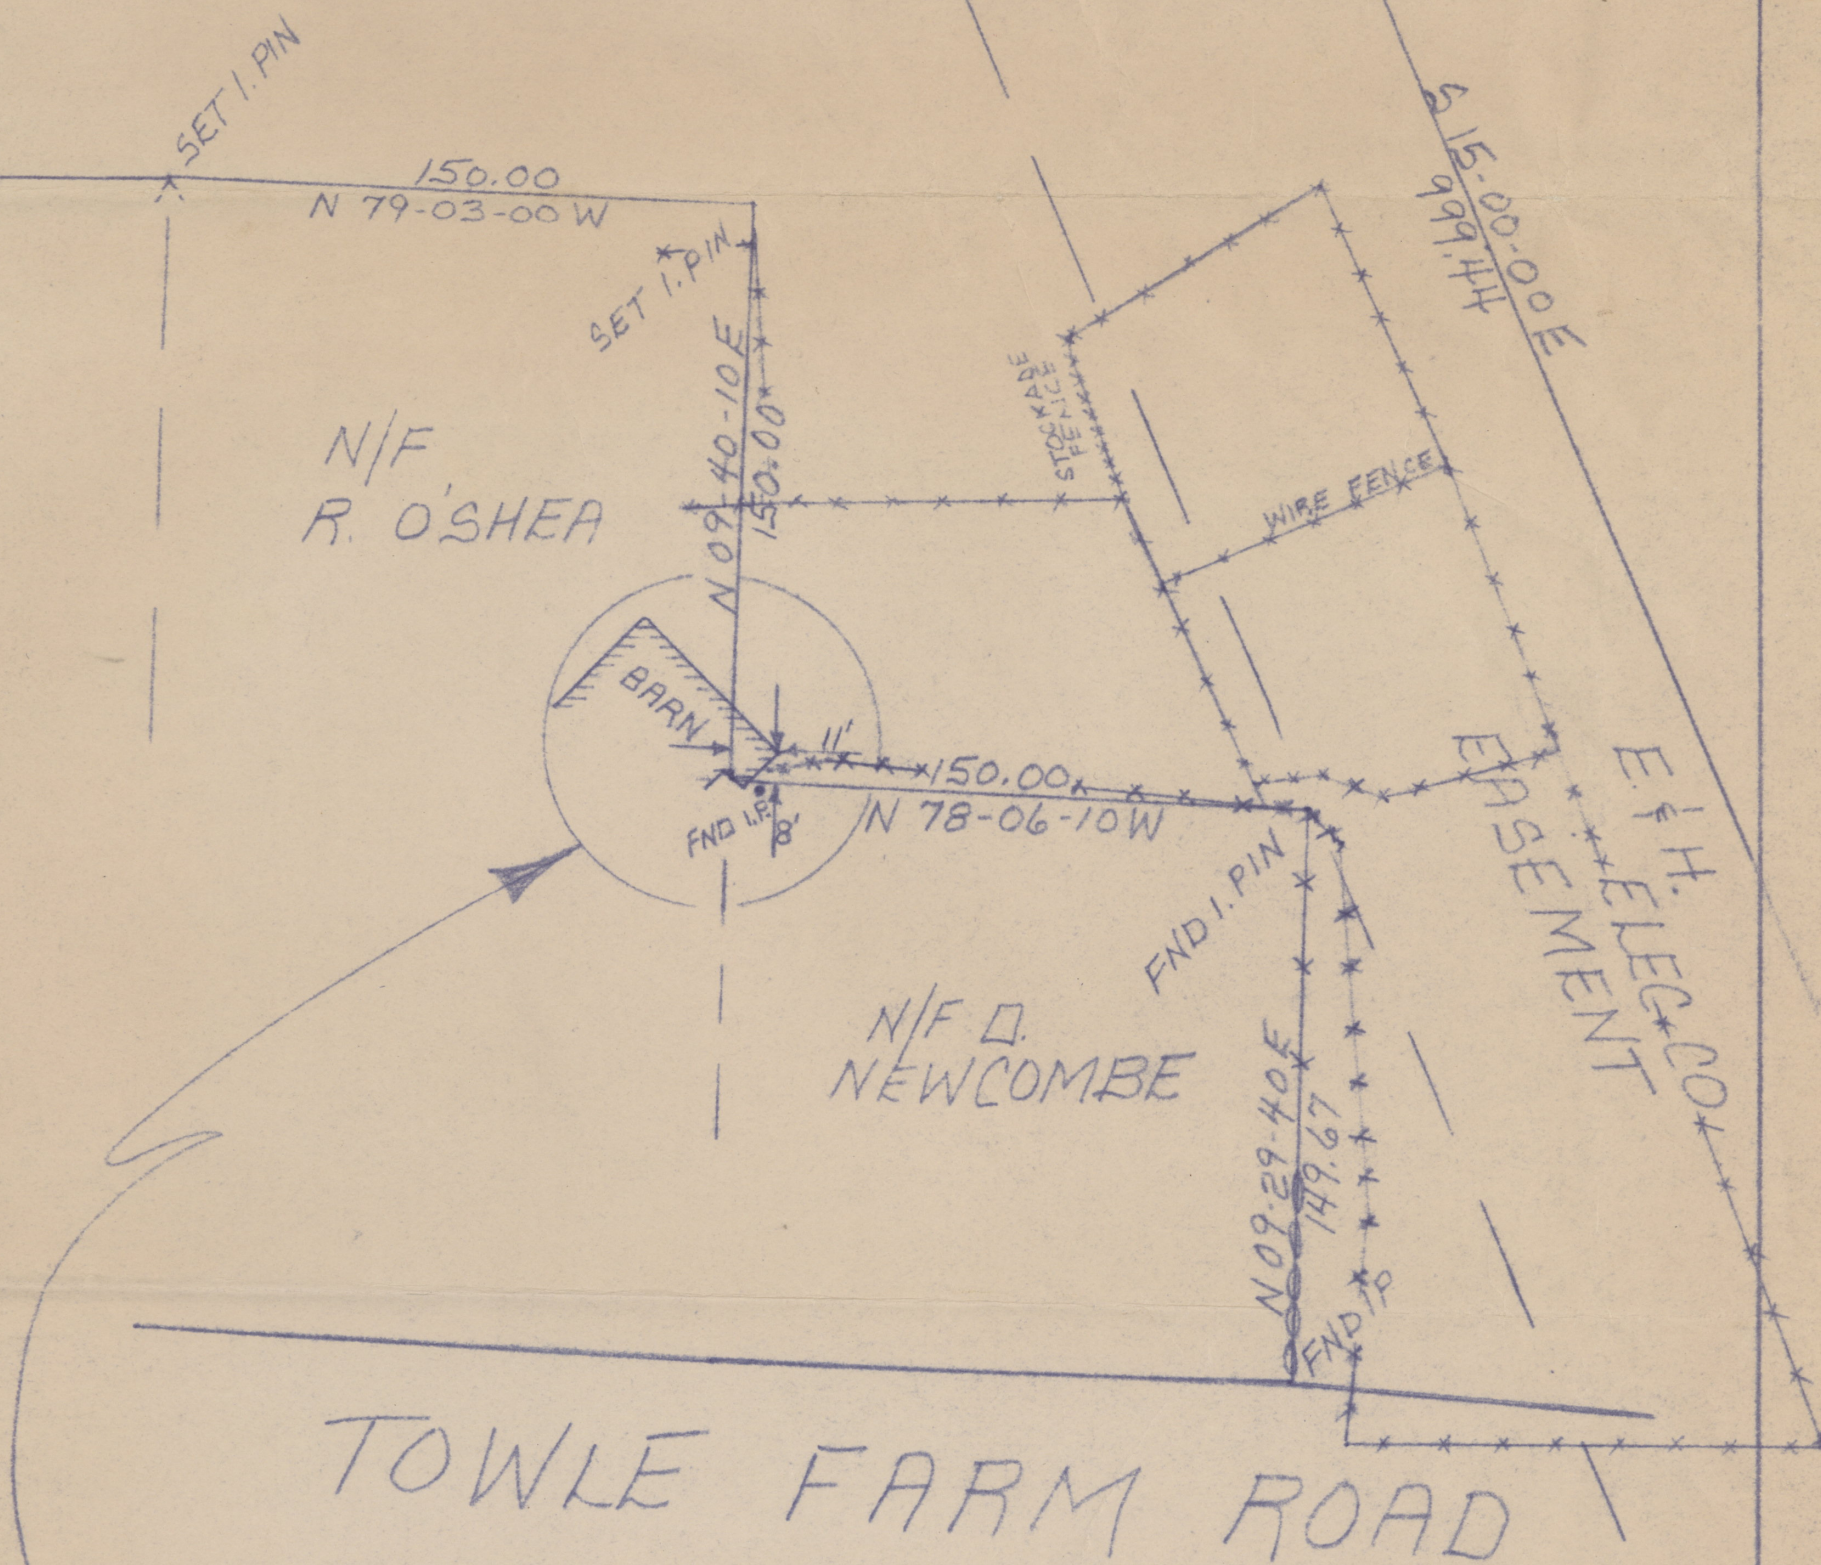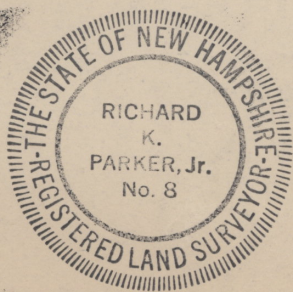

3384